E.D.A. PROJ. NO. 06-01-02225

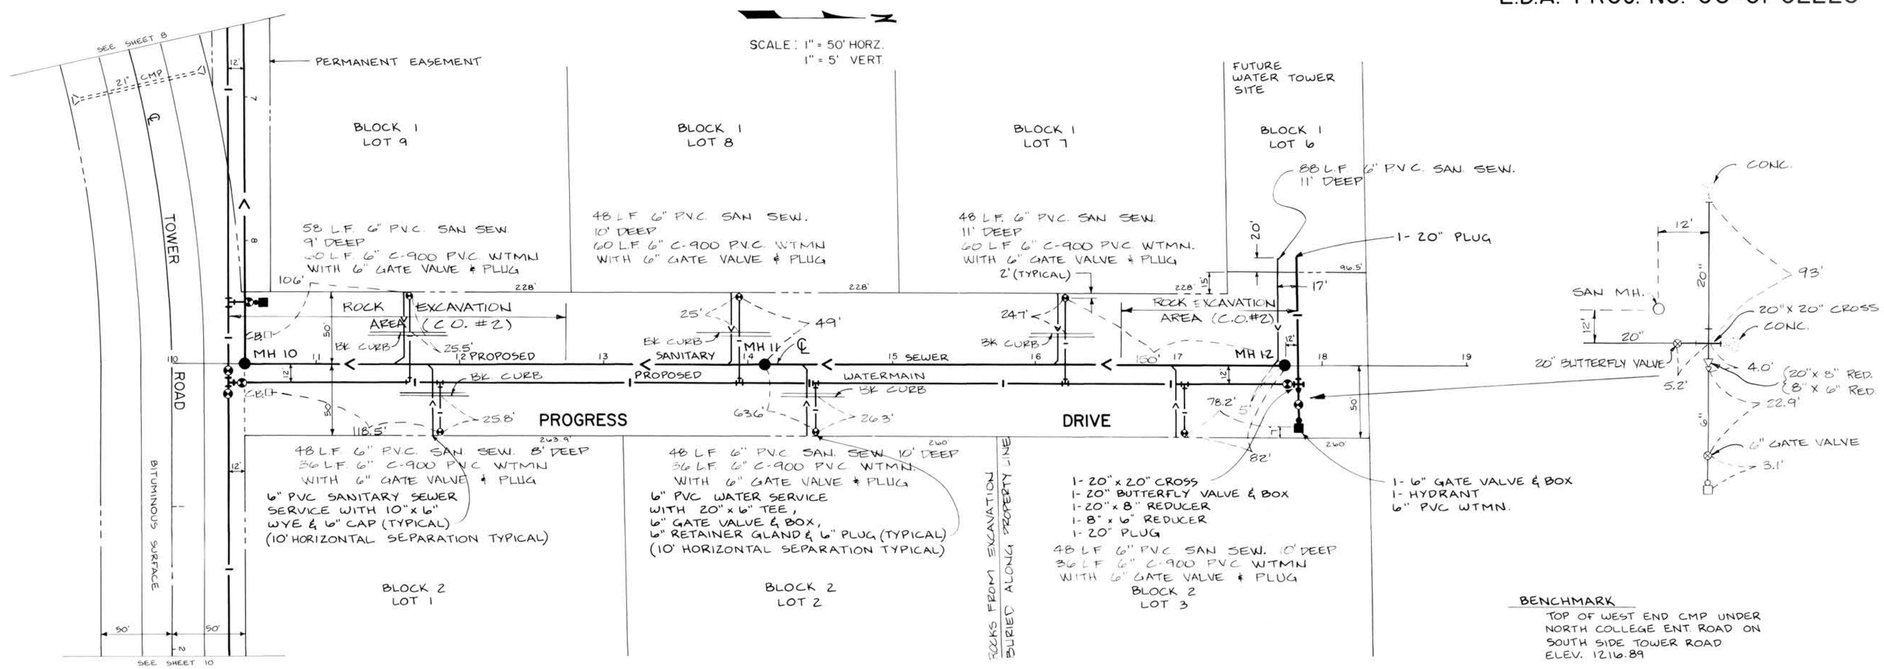

BENCHMARK
SPK. IN POWER POLE NORTH OF ENTRANCE TO RUSTAND FARM ON WEST SIDE OF TOWER ROAD
ELEV. 1233.59

BENCHMARK
TOP OF WEST END CMP UNDER NORTH COLLEGE ENT. ROAD ON SOUTH SIDE TOWER ROAD
ELEV. 1216.89

PROGRESS DR. WATERMAIN & SANITARY SEWER FROM M.H.#10 - M.H.#12

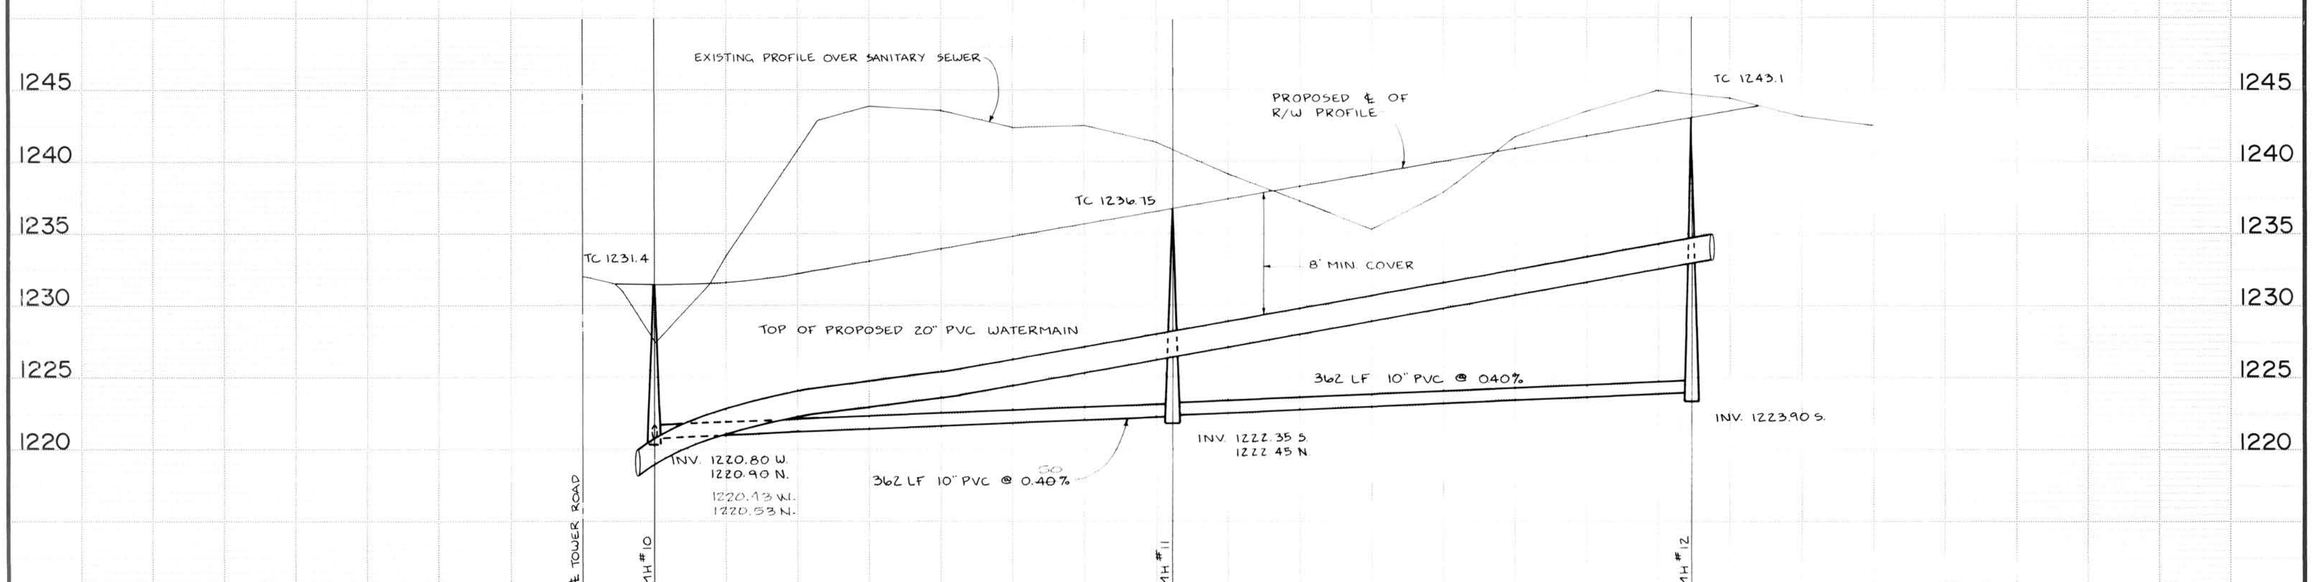

RECORD DRAWING 9-1988

355

FERGUS FALLS CITY PROJECT NO. 531-11
WIDSETH, SMITH & NOLTING PROJECT NO. 342A006